

OIPE
 DEC 26 2002
 PATENT & TRADEMARK OFFICE

Approved
 HAB

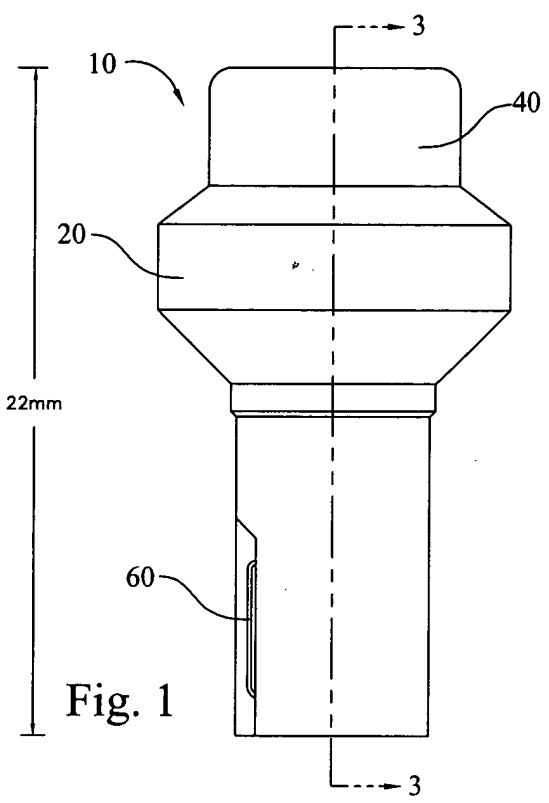


Fig. 1

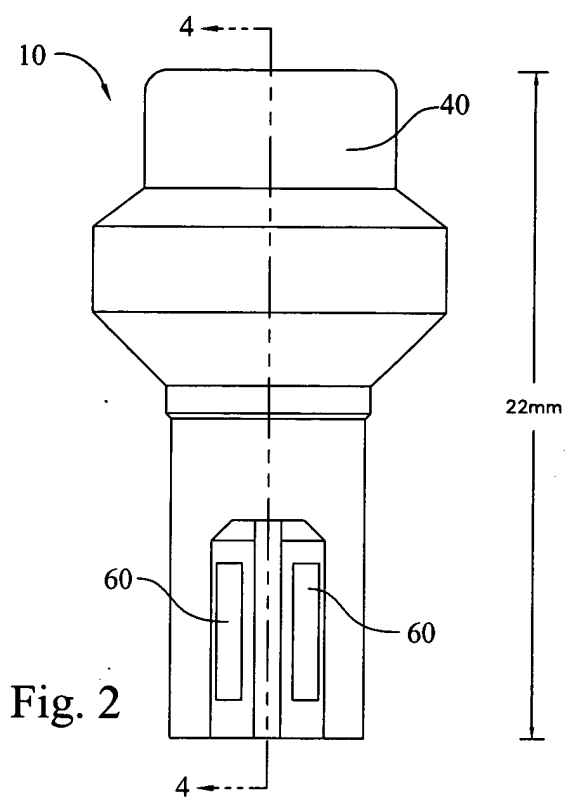


Fig. 2

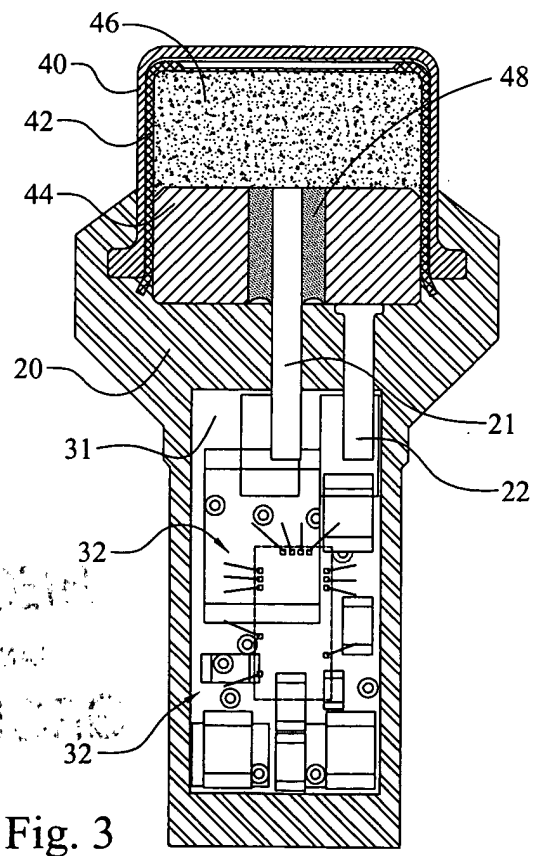


Fig. 3


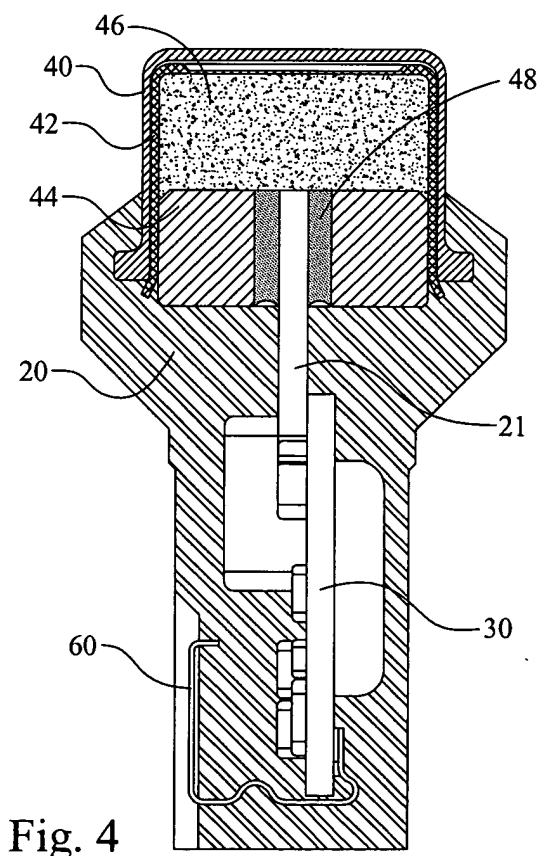


Fig. 4

RECEIVED
 12/26/02
 10:00 AM

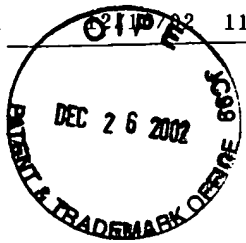

11:48 FAX

redlined version

002

Approved
HAB

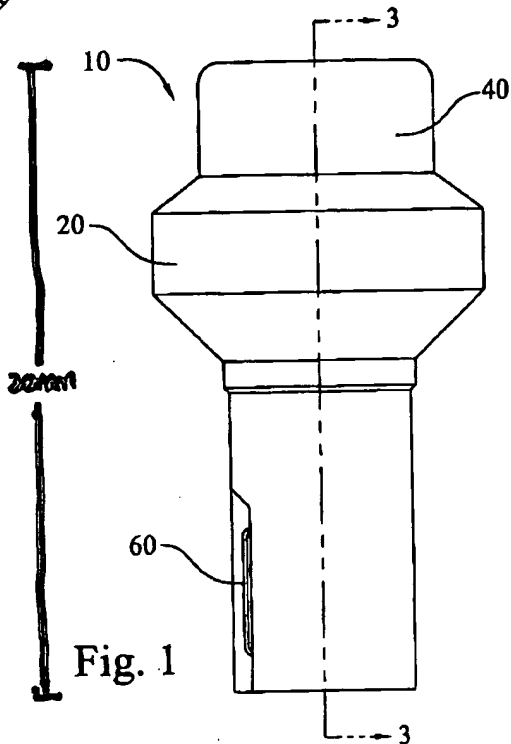


Fig. 1

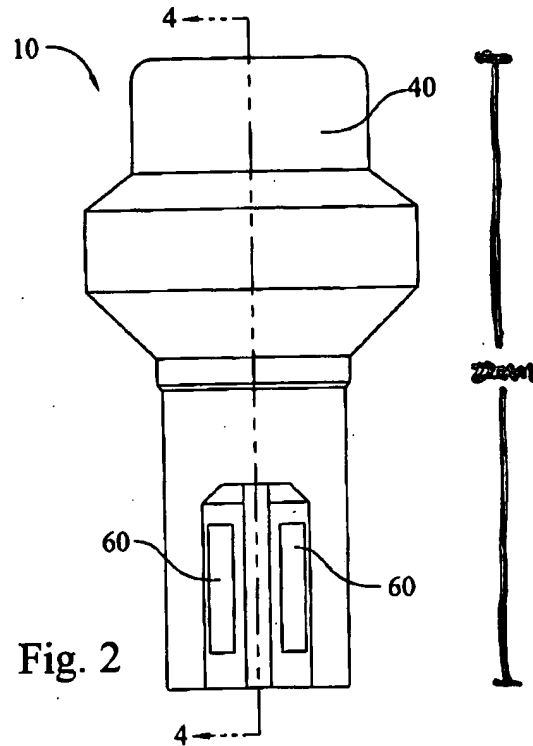


Fig. 2

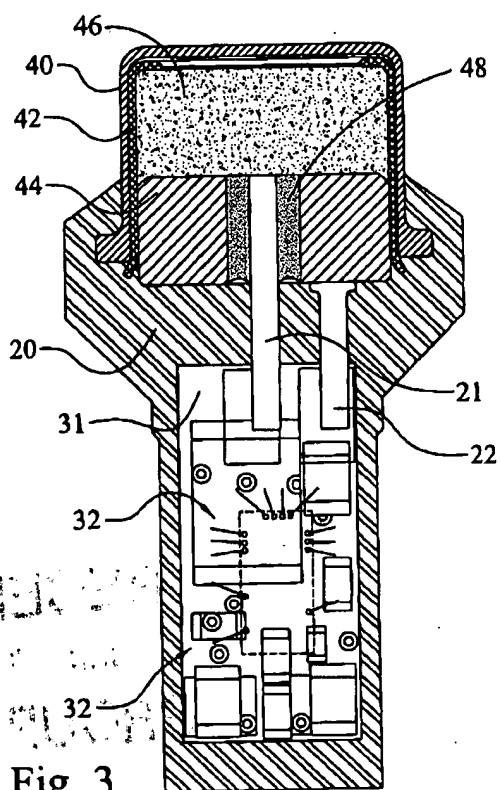


Fig. 3

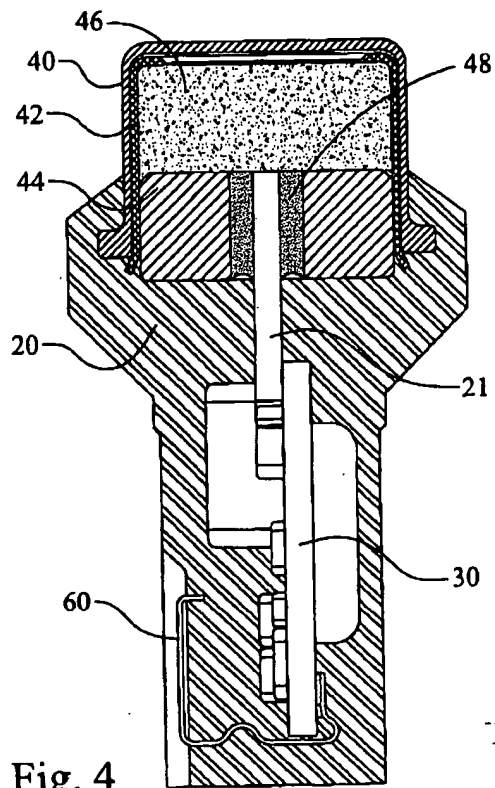


Fig. 4